


# 5700 West Olive . Glendale

Suite 106 - 1,136 RSF

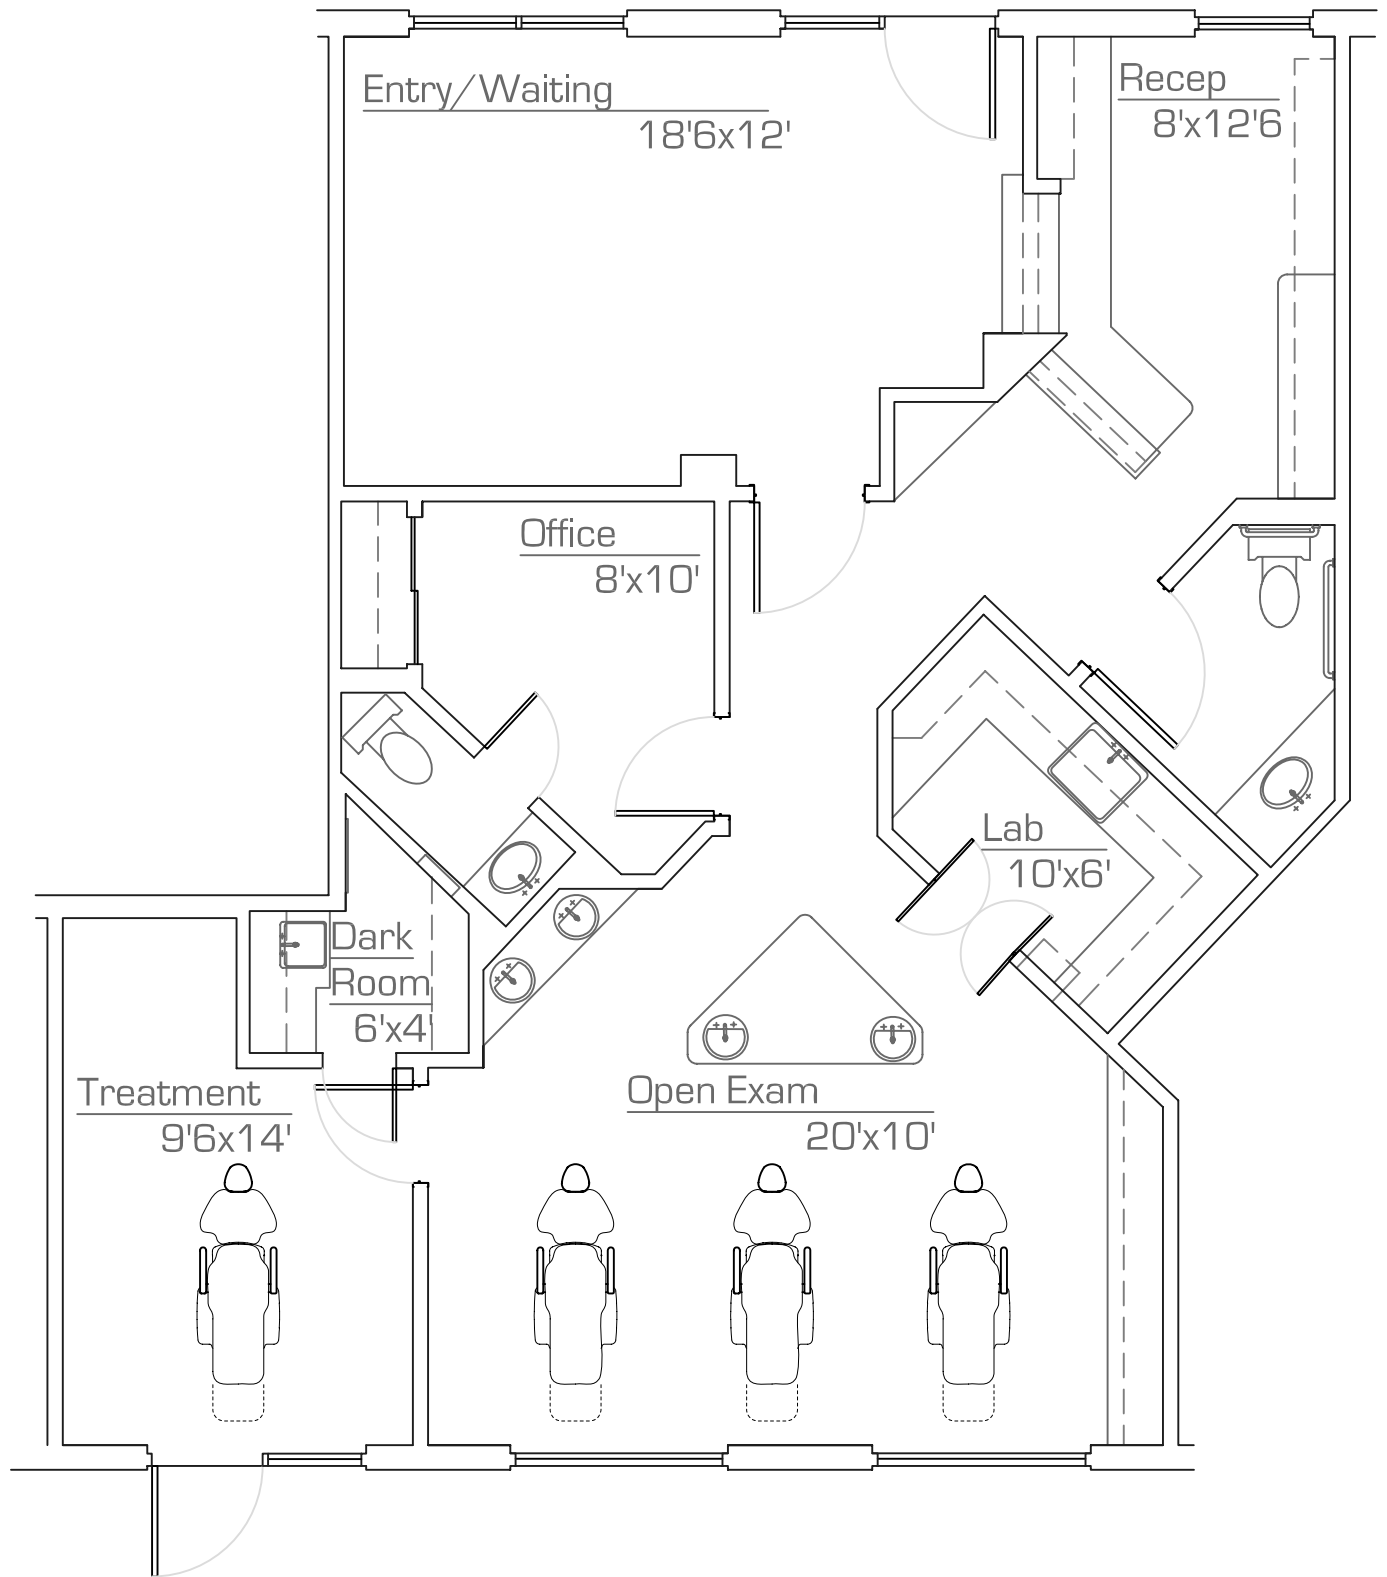

**As-Built**

scale: nts

May, 2007

\*All dimensions are approximate and all information is of general nature.

precision**MEASUREMENTS**



as-built . space plans  
architectural design

602.790.6412