


5700 West Olive . Glendale

Suite 106 - 1,136 RSF

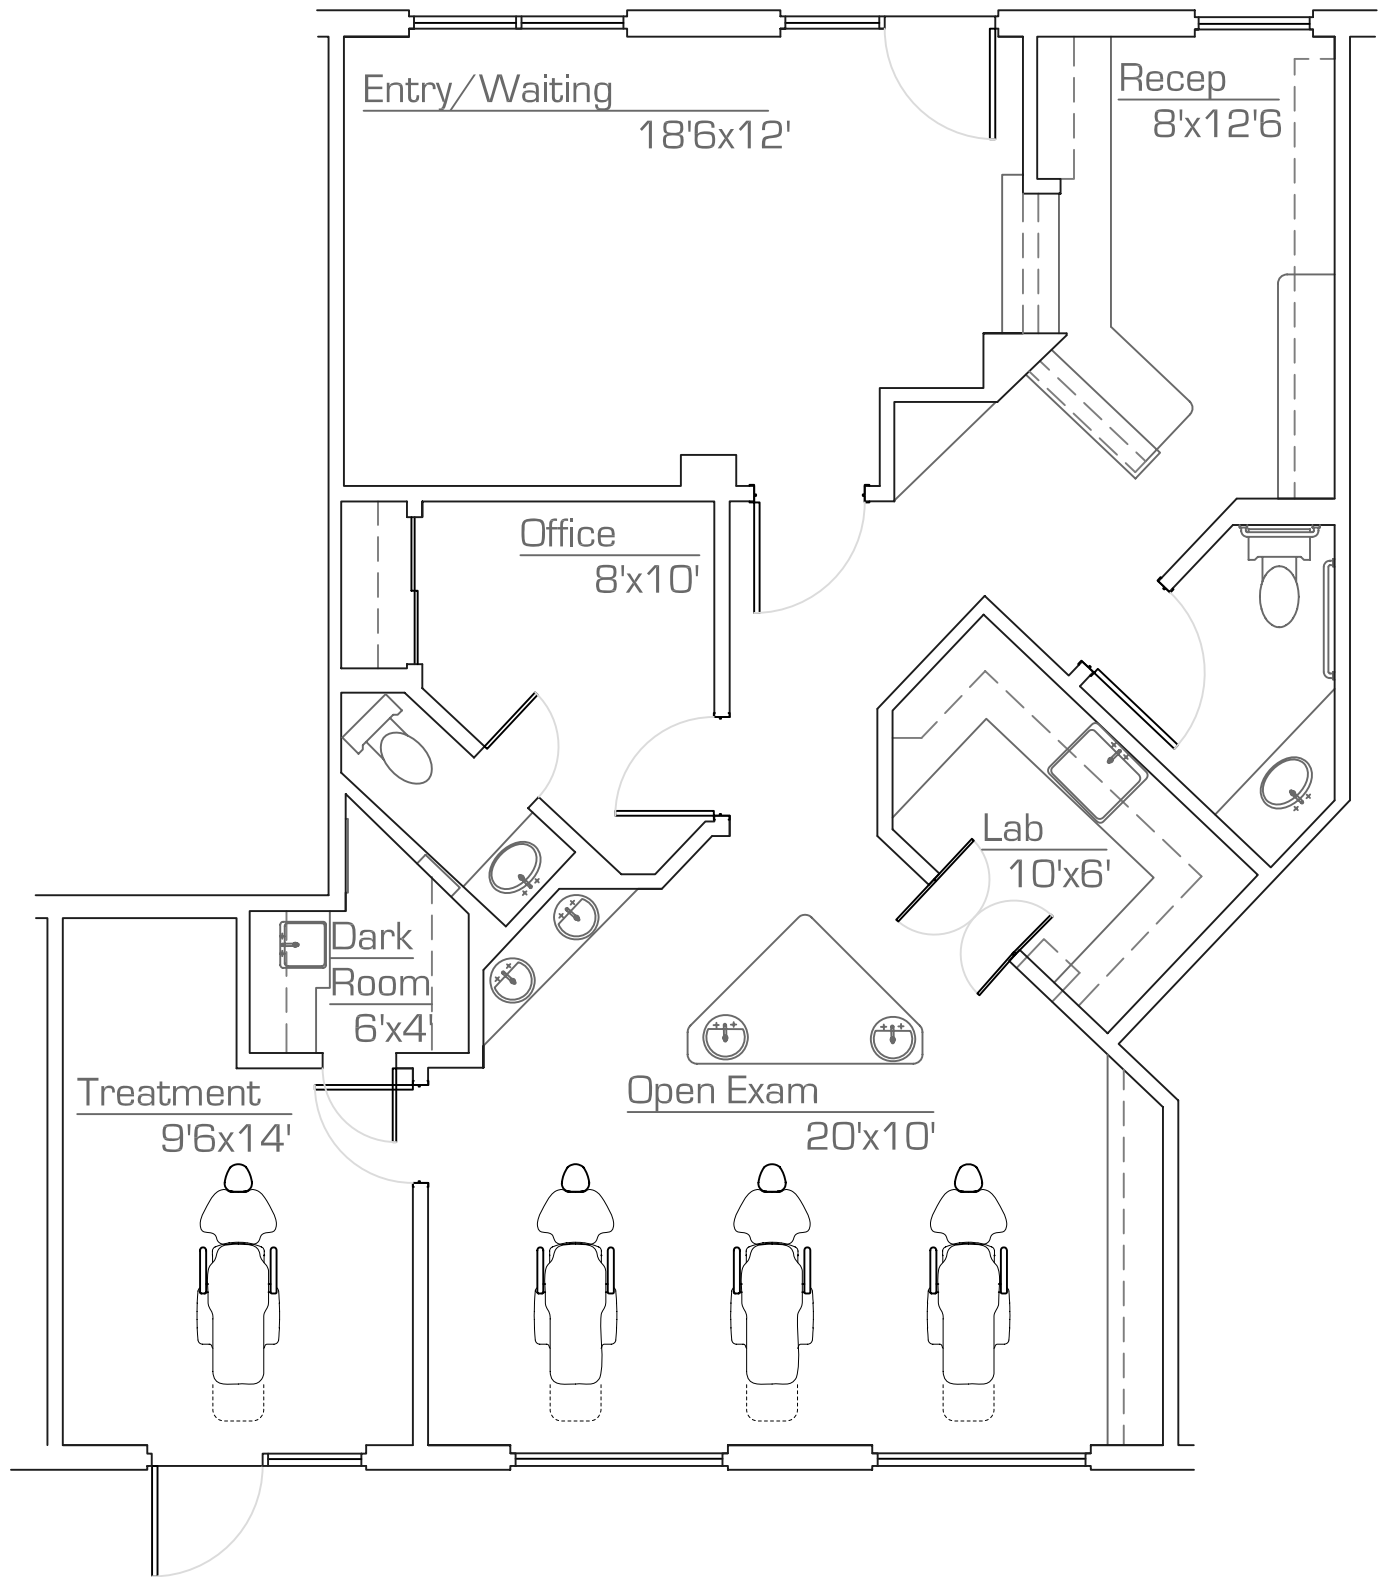

As-Built

scale: nts

May, 2007

*All dimensions are approximate and all information is of general nature.

precision**MEASUREMENTS**



as-built . space plans
architectural design

602.790.6412