


Koll Cotton Center

4050 East Cotton Center Boulevard

Suite 33 - 3,315 RSF

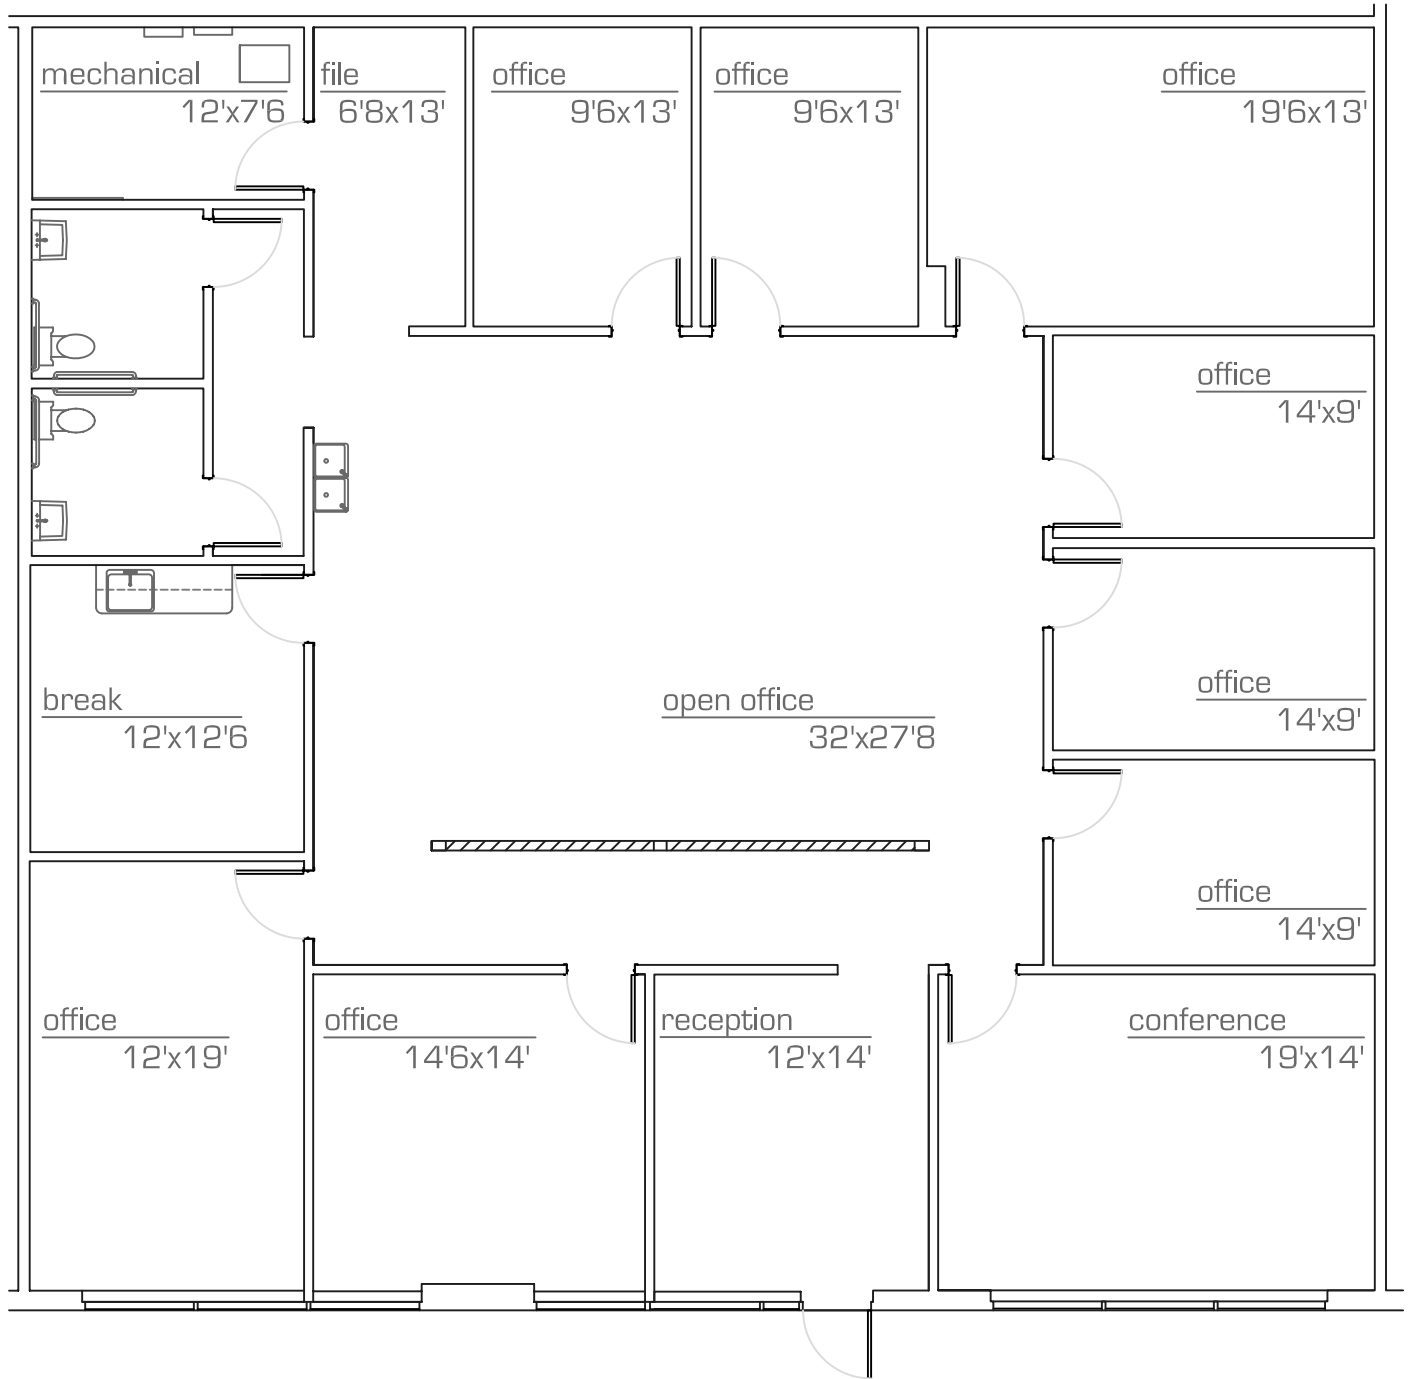


as-built

scale: nts

6.April.2007

*All dimensions are approximate and all information is of general nature.

precision**MEASUREMENTS**

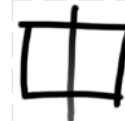

as-built . space plans
architectural design

602.790.6412