


North 3rd Avenue

West Roosevelt Street

Alley

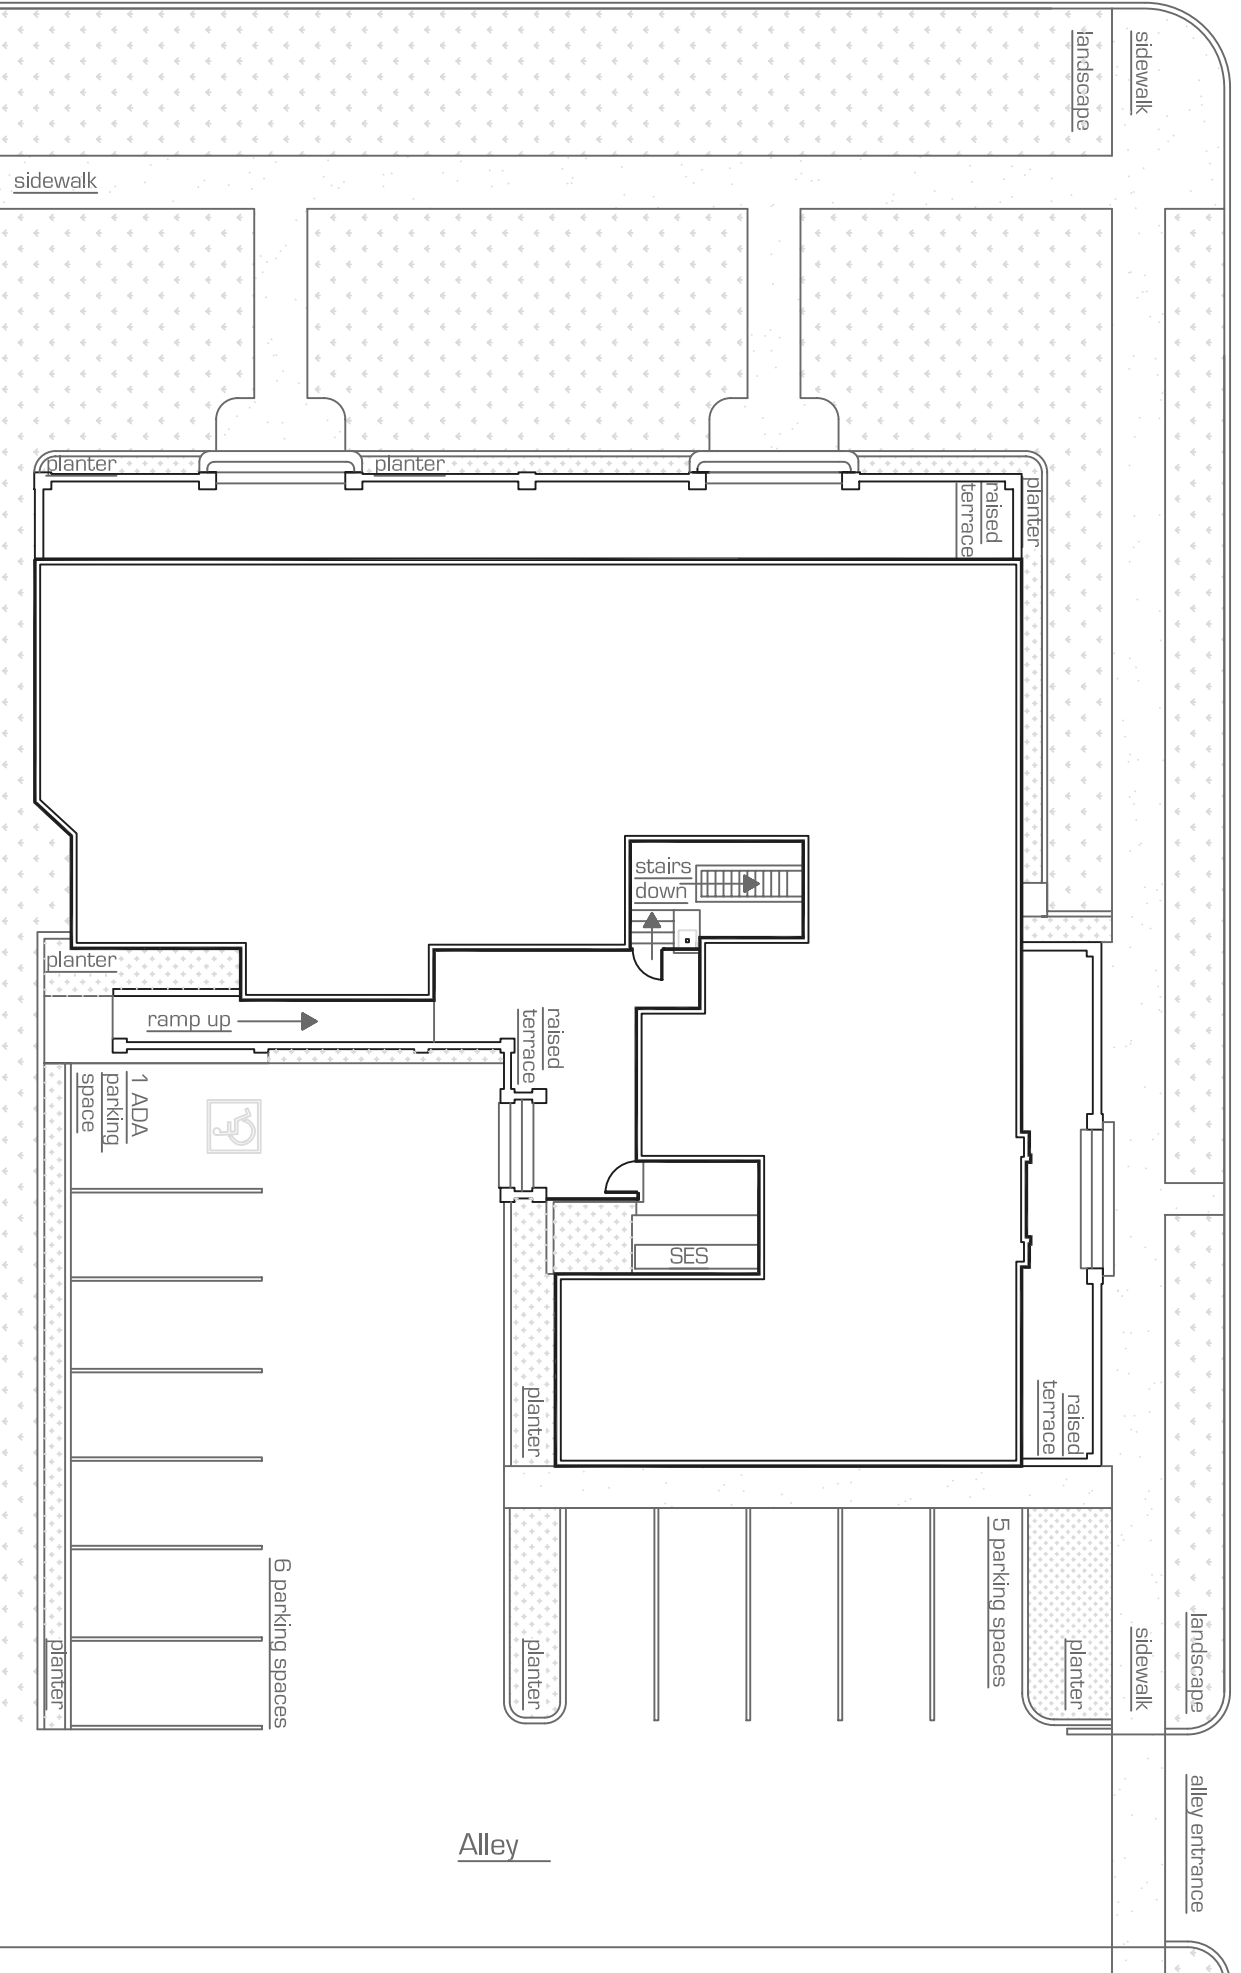

schematic site plan

scale: nts
September.2008

* All dimensions are approximate
* All information is of general nature

845 North 3rd Avenue Phoenix

precision MEASUREMENTS

as built . space plans
architectural design

6 0 2 . 7 9 0 . 6 4 1 2

