


Koll Cotton Center

4050 East Cotton Center Boulevard

Suite 63 - 3,227 RSF

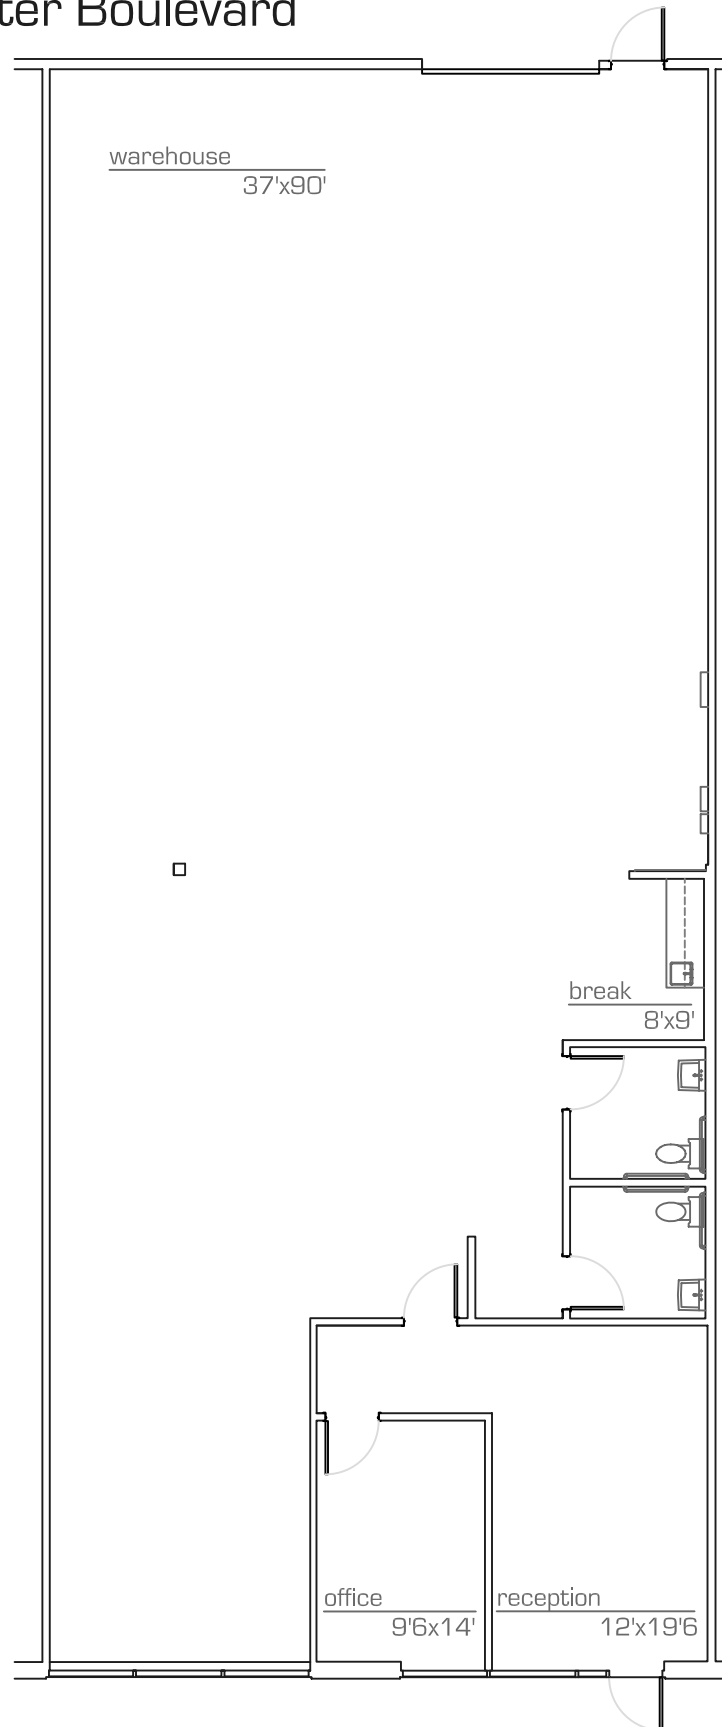

as-built

scale: nts

27.nov.2006

*All dimensions are approximate and all information is of general nature.

precision**MEASUREMENTS**



as-built . space plans
architectural design

602.790.6412