


# Koll Cotton Center

4050 East Cotton Center Boulevard

Suite 66 - 4,282 SF

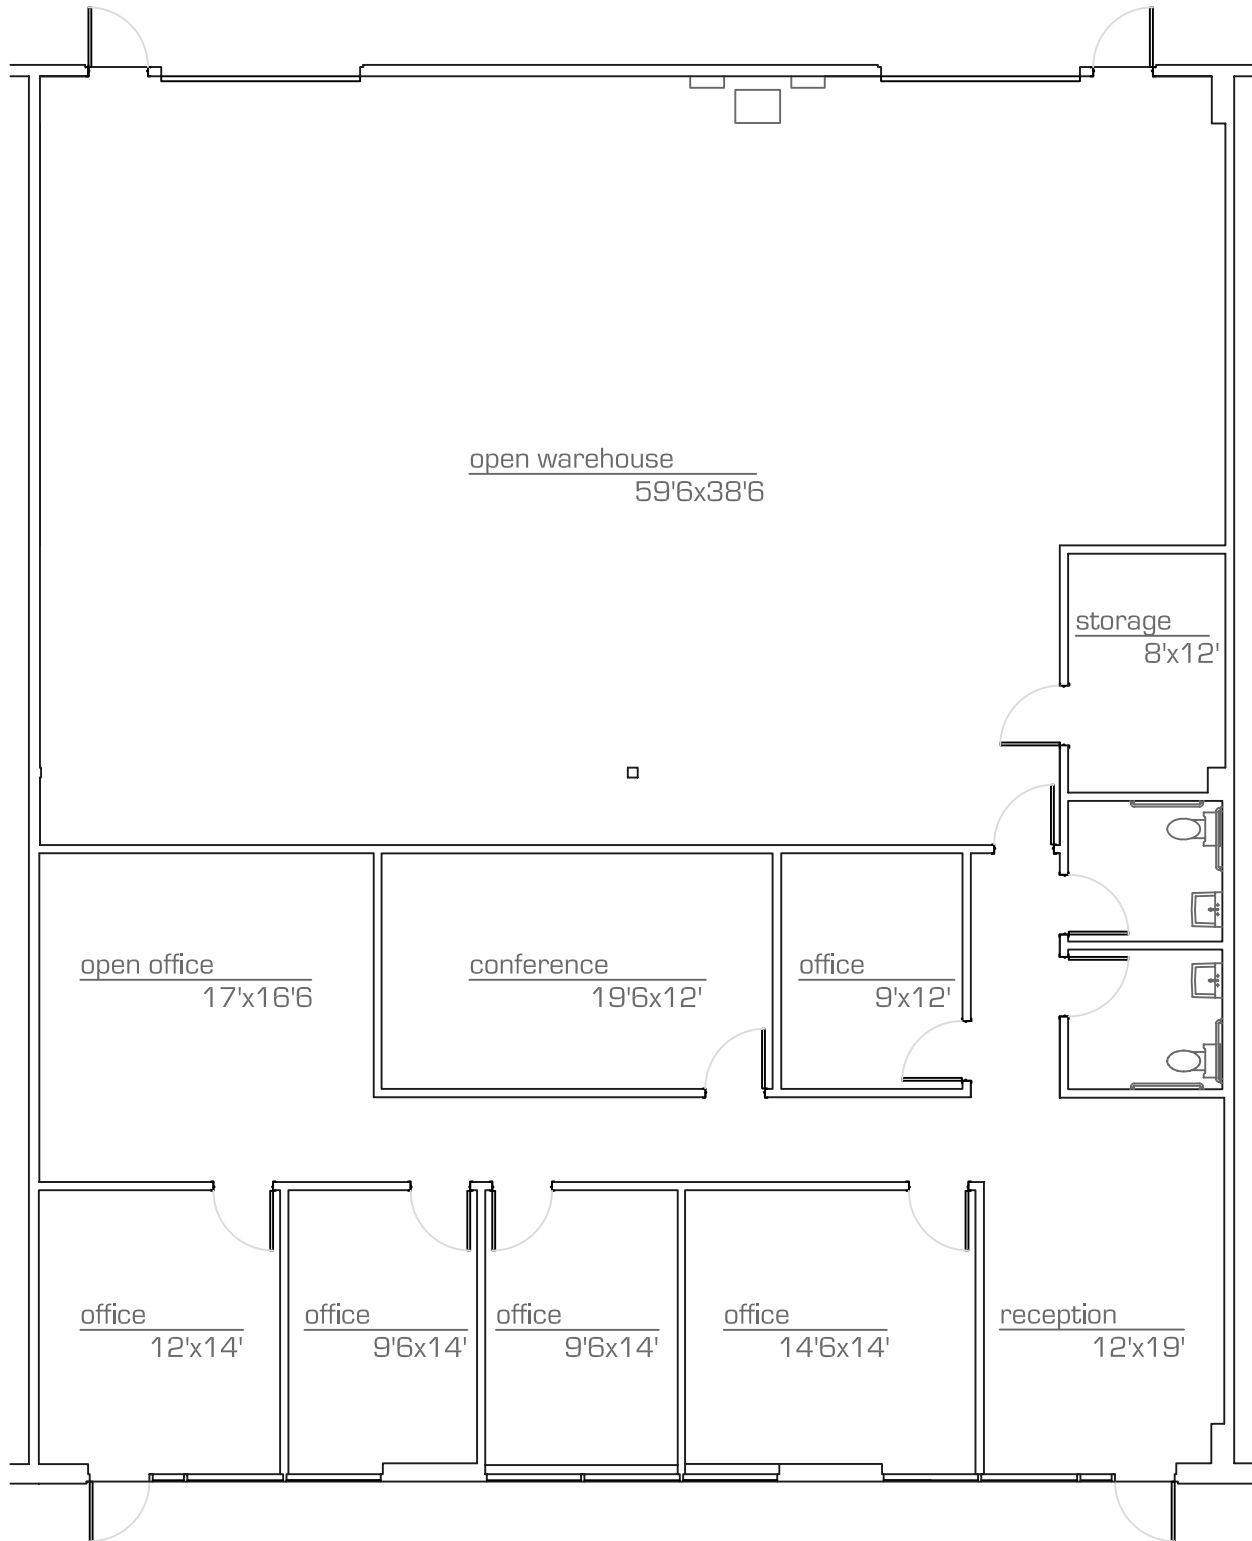

**as-built**

scale: nts

16.aug.2006

\*All dimensions are approximate and all information is of general nature.

precision**MEASUREMENTS**



as-built . space plans  
architectural design

602.790.6412